


AS-BUILT RECORD

THE CONTRACTOR VERIFIES ALL INFORMATION PROVIDED BY THE CONTRACTOR AND REPRESENTED ON THIS DRAWING IS CORRECT AT THE DATE OF ISSUE.

Contractor:

Contractor Contact Name:


Contractor Contact Signature and Date:

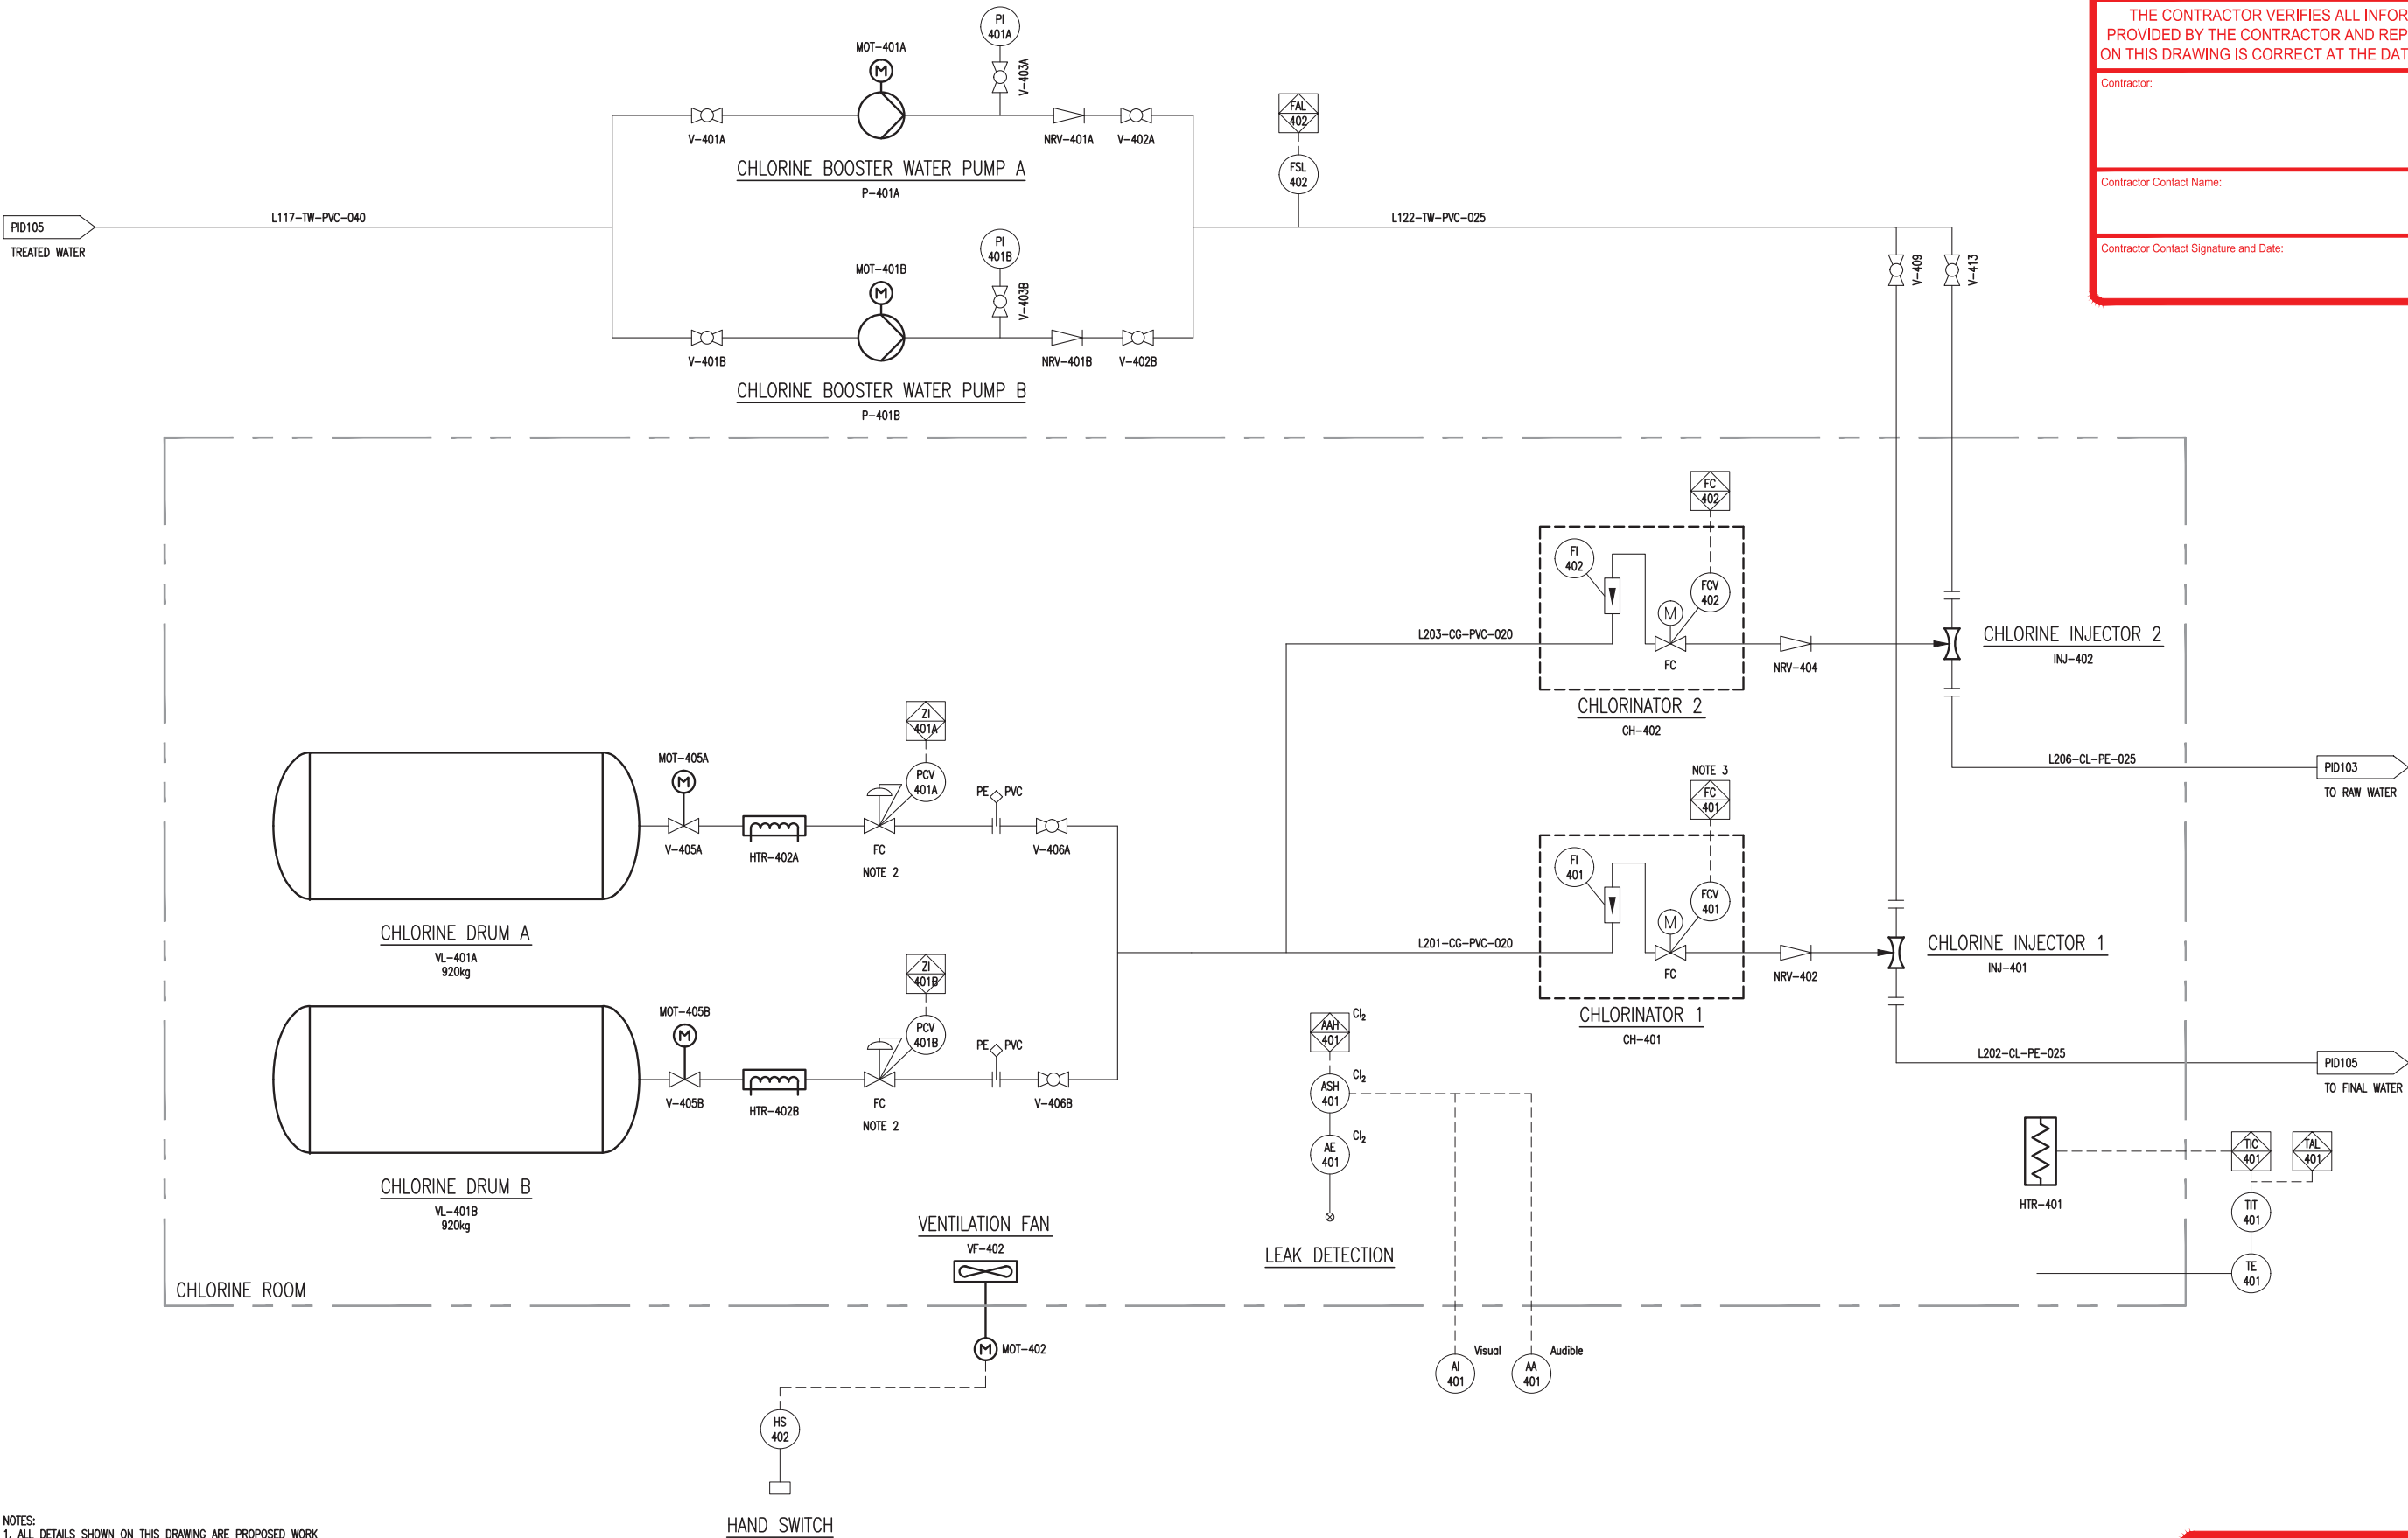

- NOTES:
1. ALL DETAILS SHOWN ON THIS DRAWING ARE PROPOSED WORK
 2. VACUUM REGULATOR VENTS TO BE ROUTED TO THE FLOOR INSIDE THE CHLORINE ROOM (USING PE TUBING)
 3. CONTROLLED BY MEASUREMENT FROM AIC-301A (REFER PID-105)

AS-BUILT

				DESIGNED: JBC	DATE: 18.04.12	SIGNED:		PLOT BY: VAP	DATE:	HDC ASSET MANAGER:		ASSOCIATION OF CONSULTING ENGINEERS NEW ZEALAND	ISO 9001 QUALITY ASSURED			PROJECT: HAURAKI DISTRICT COUNCIL KEREPEHI WTP	TITLE: PROCESS AND INSTRUMENTATION DIAGRAM CHLORINE DOSING SYSTEM	ISSUE STATUS: AS-BUILT		
				DRAWN: NLB	DATE: 18.04.12	SIGNED:		PLOT DATE: 26.02.13	DATE:									PROJECT No: 1014-129544-01	SCALES: NTS	A3
				CHECKED: EBT	DATE: 18.04.12	SIGNED:		SURVEY BY:	HDC DISTRICT ENGINEER:	THIS DRAWING AND DESIGN REMAINS THE PROPERTY OF AND MAY NOT BE REPRODUCED OR ALTERED, WITHOUT THE WRITTEN PERMISSION OF HARRISON GRIERSON CONSULTANTS LIMITED. NO LIABILITY SHALL BE ACCEPTED FOR UNAUTHORISED USE OF THIS DRAWING.								DRAWING No:		REV
A REF	AS-BUILT REVISIONS	NLB	31.01.12	APPROVED: IGR	DATE: 18.04.12	SIGNED:		SURVEY DATE:	DATE:		129544-PID107-AB		A							

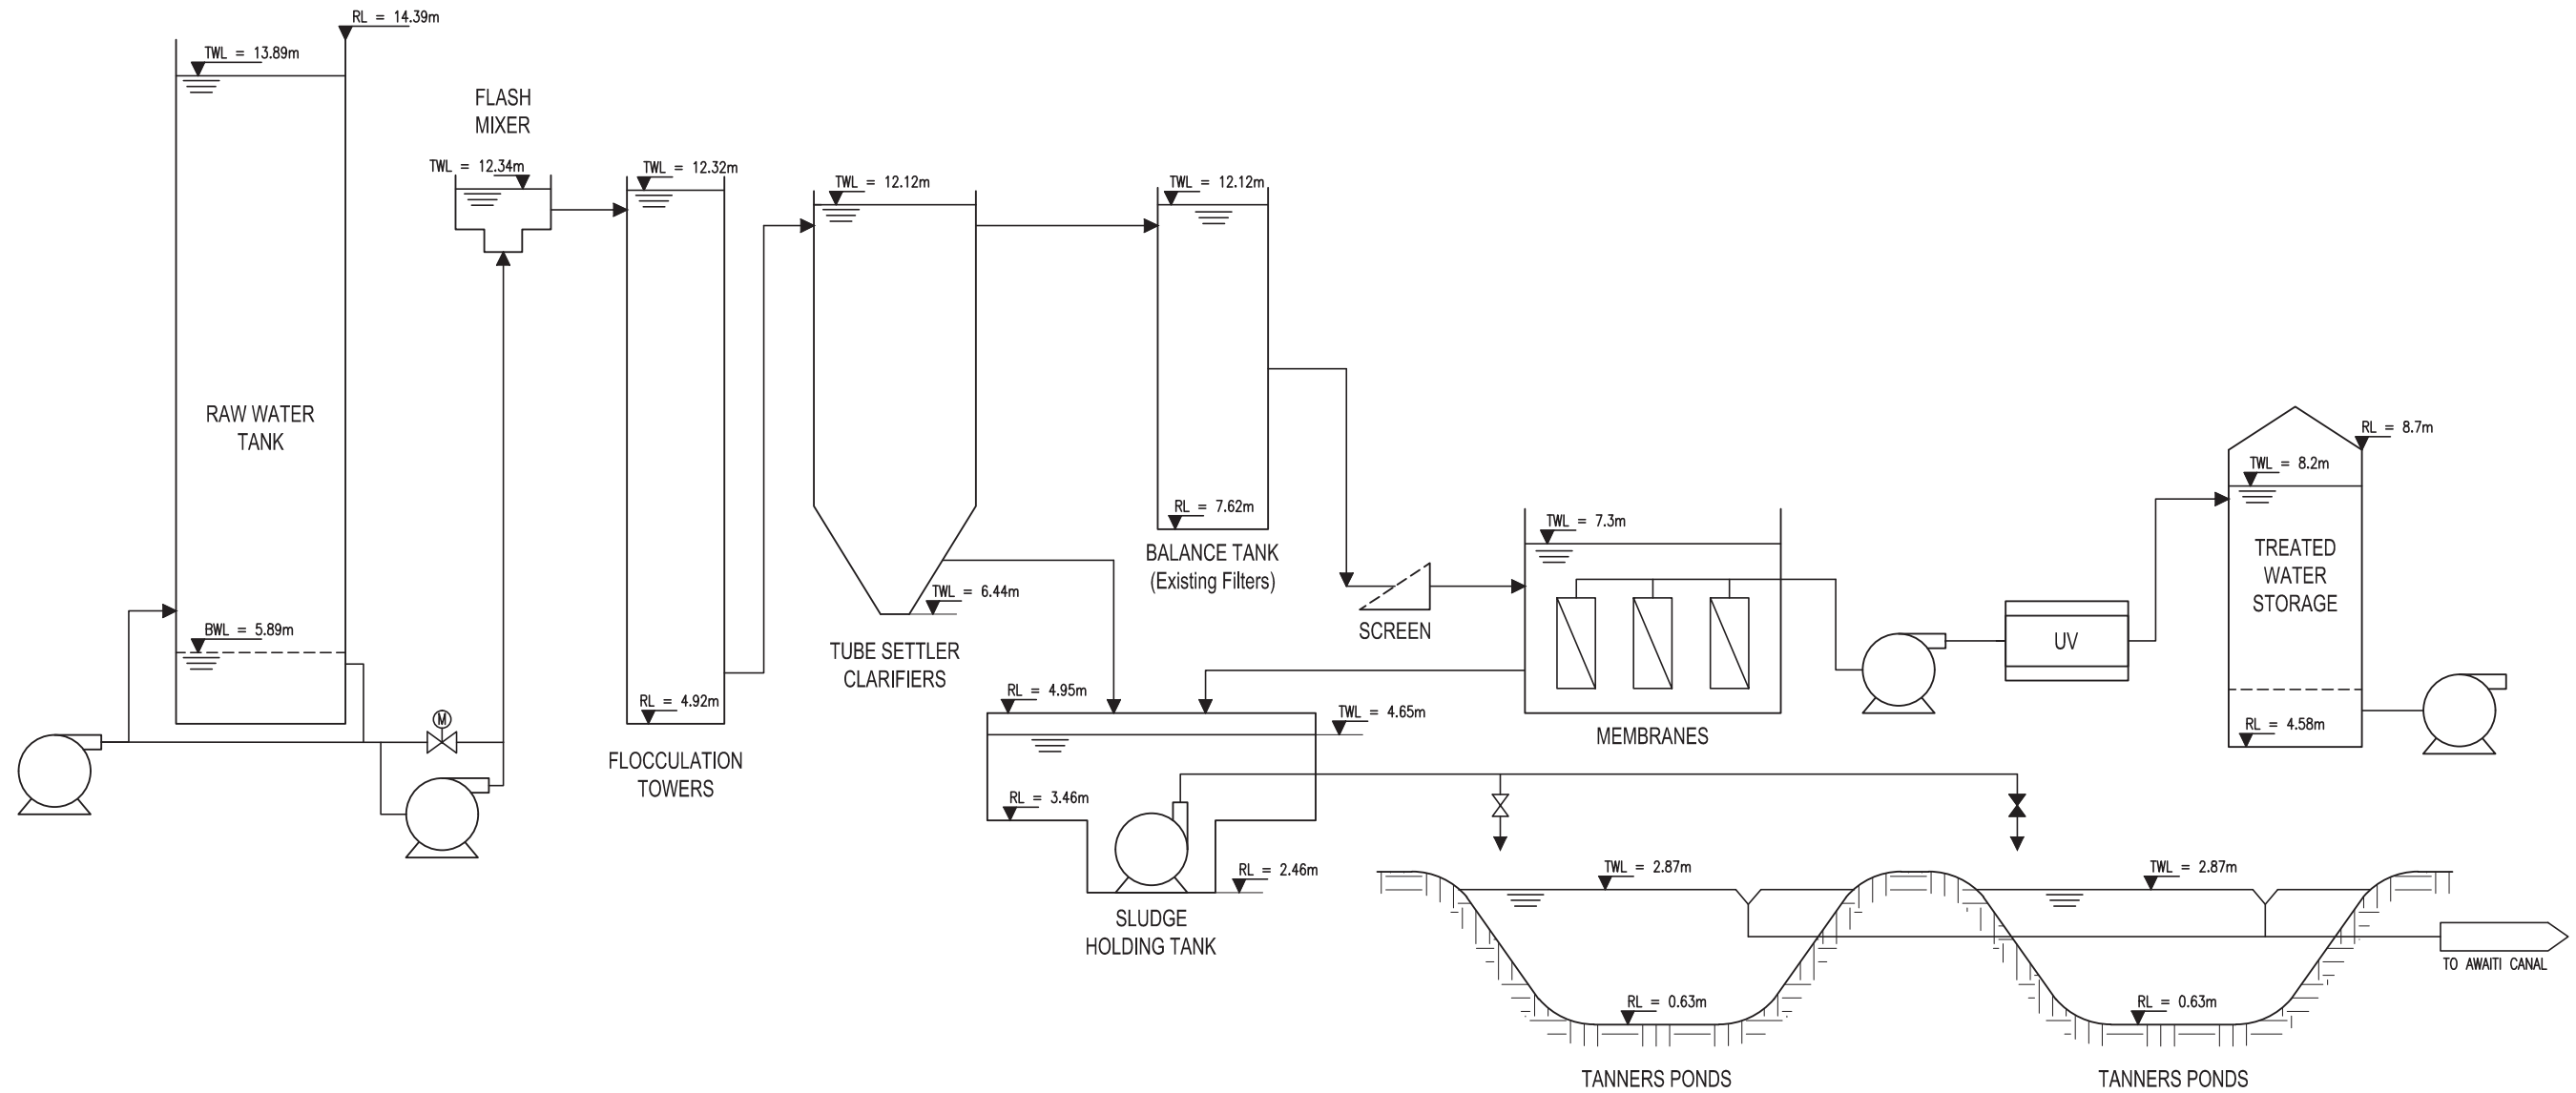

NOTES:
1. RL's ARE TO TARARU VERTICAL DATUM

AS-BUILT

				DESIGNED: NLB	DATE: 25.10.11	SIGNED:	PLOT BY: VAP	HDC ASSET MANAGER:		ASSOCIATION OF CONSULTING ENGINEERS NEW ZEALAND	ISO 9001 QUALITY ASSURED		PROJECT: HAURAKI DISTRICT COUNCIL KEREPEHI WTP	TITLE: HYDRAULIC PROFILE	ISSUE STATUS: AS-BUILT
				DRAWN: NLB	DATE: 25.10.11	SIGNED:	PLOT DATE: 31.01.13	DATE:							PROJECT No: 1014-129544-01
				CHECKED: EBT	DATE: 16.11.11	SIGNED:	SURVEY BY:	HDC DISTRICT ENGINEER:							SCALES: NTS
				DATE: 16.11.11	SIGNED:	SURVEY DATE:	DATE:								A3
A	AS-BUILT	EBT	31.01.13	APPROVED:	DATE:	SIGNED:	SURVEY DATE:	DATE:							DRAWING No:
REF	REVISIONS	BY	DATE	IGR	16.11.11										129544-HP101-AB
															REV
															A